
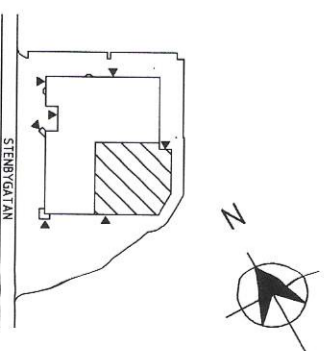


V

V

13900  
17000  
17000  
17000

4  
3  
2  
1

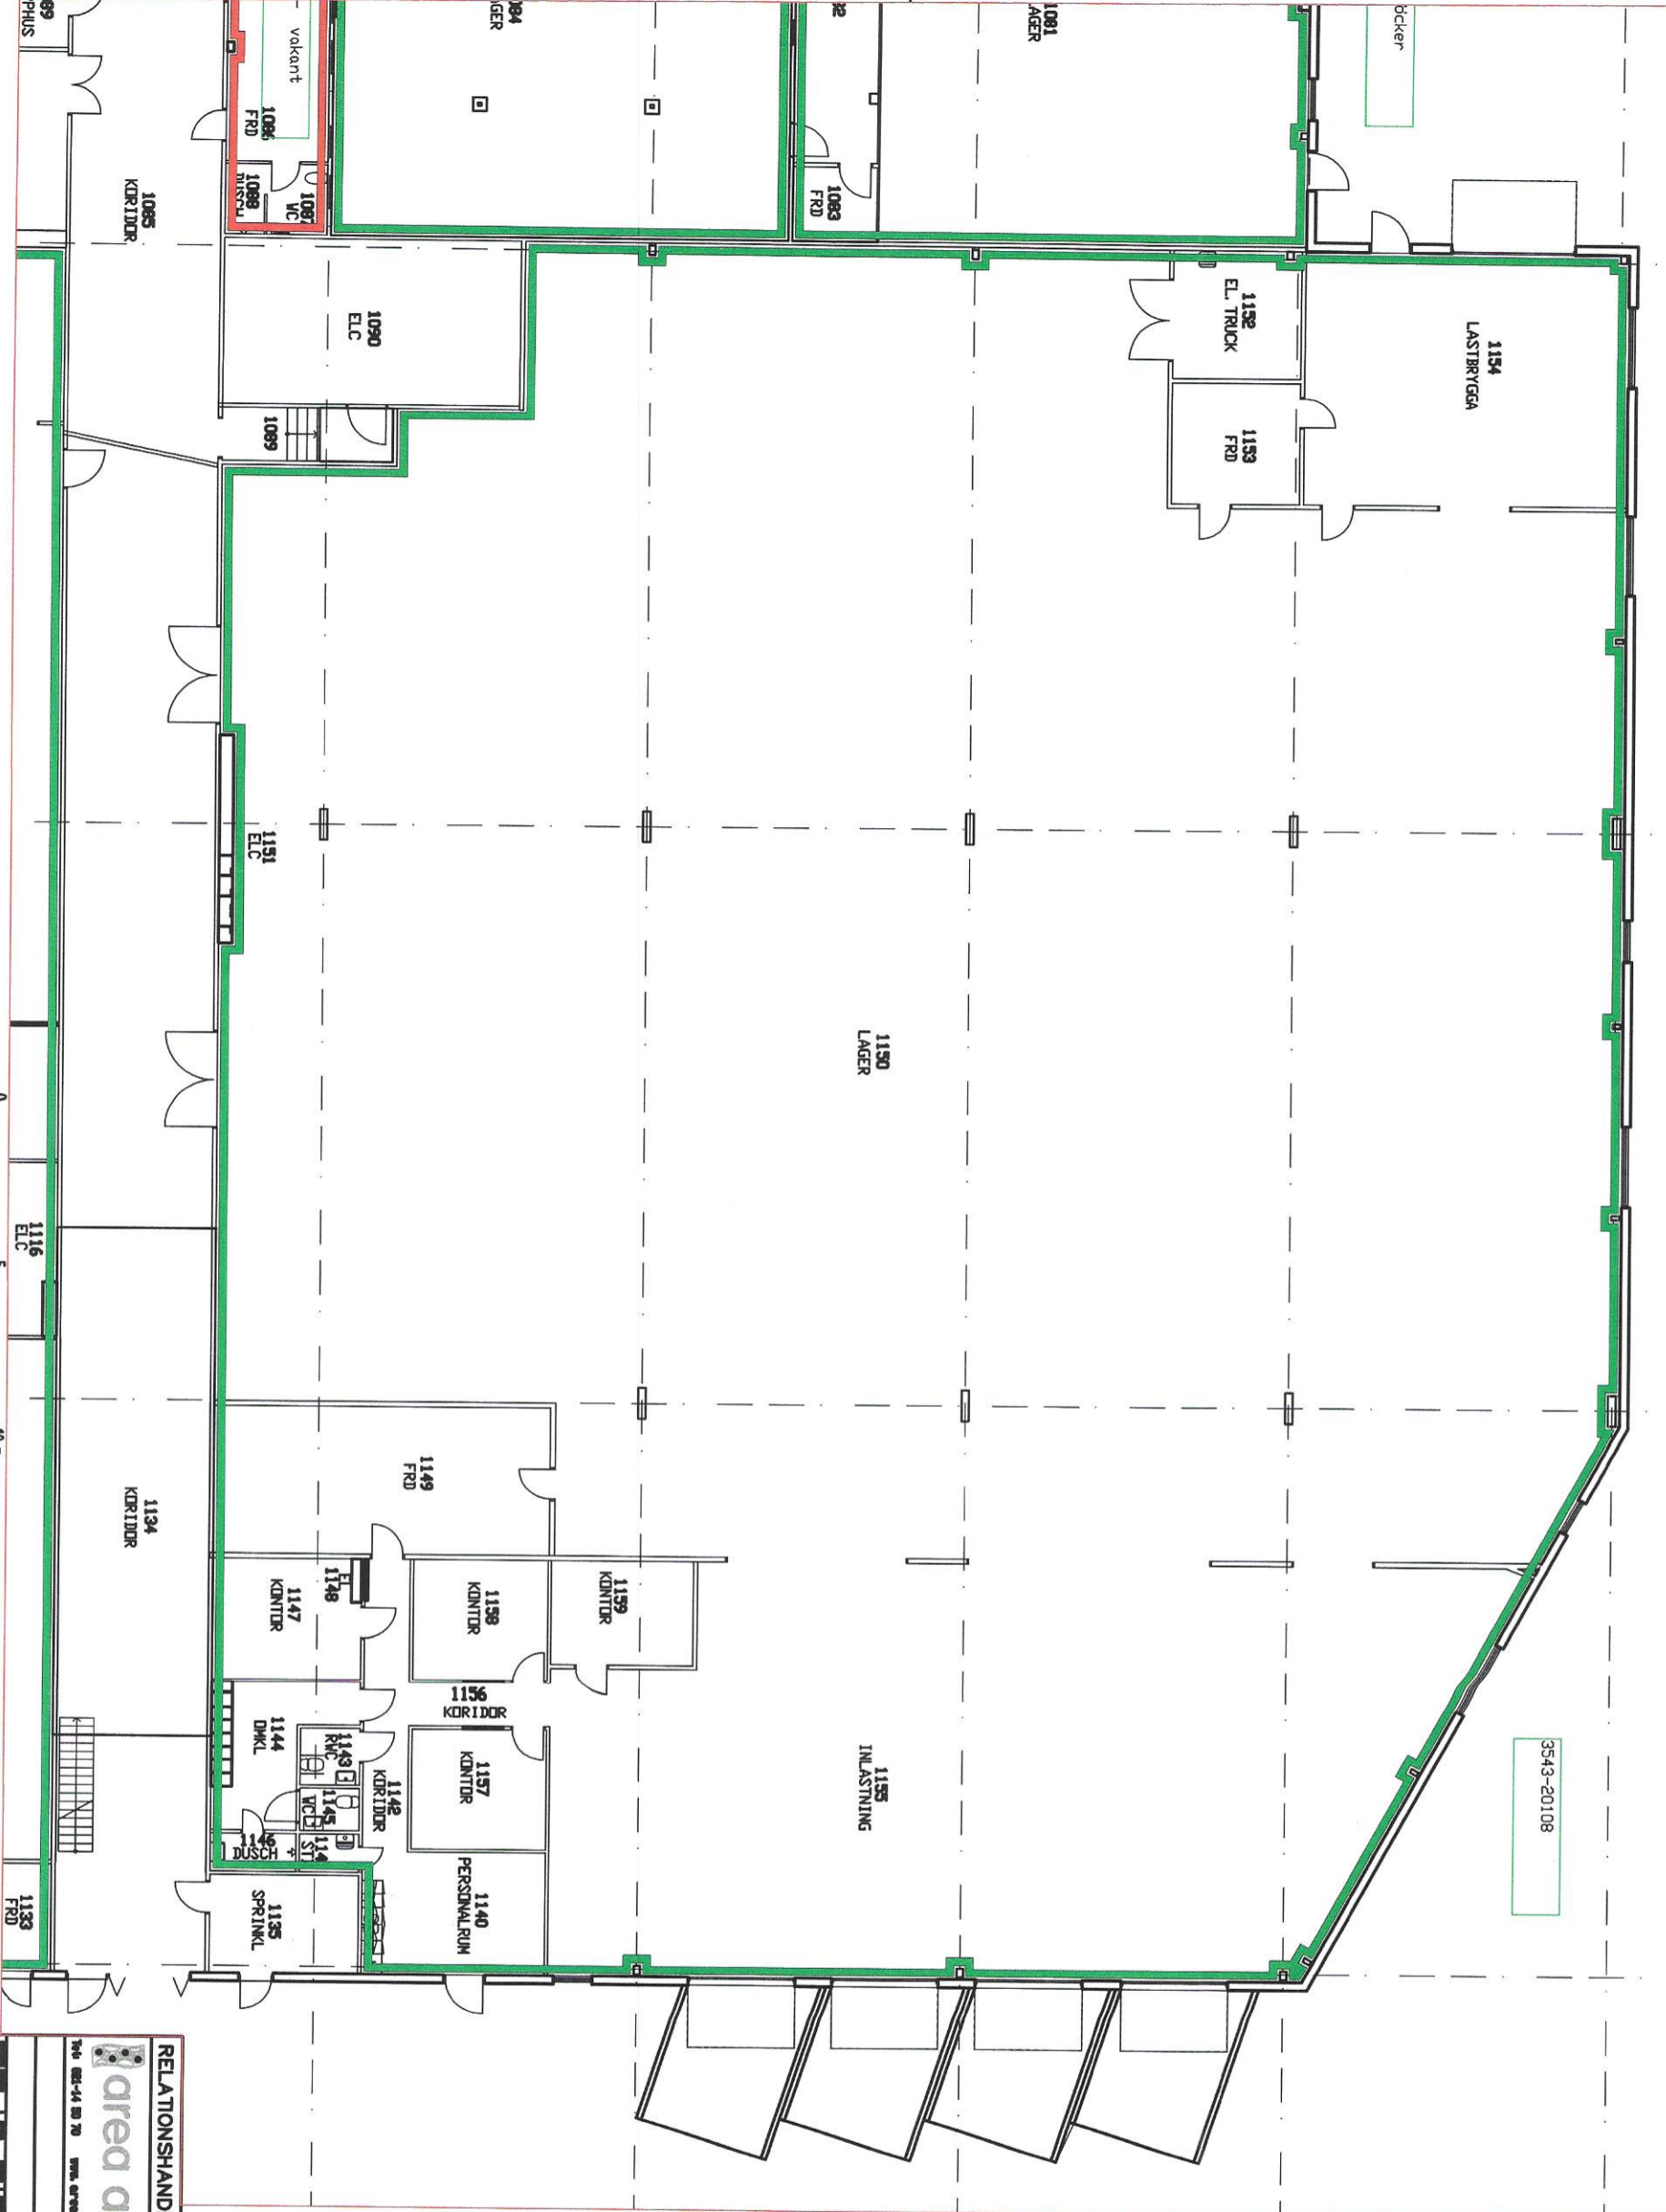

<b>RELATIONSHANDLING</b>		<b>area arc</b>	
ADRESS	TELEFON	ADRESS	TELEFON
063 00 30		063 00 30	
<b>JORDLINAN 2</b>		<b>ASPROMEN</b>	
HUS 1	FASTIGHETER AB	FASTIGHETER AB	
PLAN 1		FASTIGHETER AB	
PLANNING		FASTIGHETER AB	
DRS FRON A1	DRS FRON A9	FASTIGHETER AB	
SKALA 1:100	SKALA 1:200	FASTIGHETER AB	
<b>3543</b>	<b>A3001_02013</b>	FASTIGHETER AB	

PLÖ: 2009-02-13 11:18 F:\ARBETS ARKIV\FÄSTIGHETSAGARE\ASPROMEN\3543-JORDLINAN 2\3543-JORDLINAN-DWG\2\3543-02010\_080130.DWG ATYAF